



200 Clinton Ave W, Suite 704
Huntsville, Alabama 35801
(256) 203-9501

September 11, 2024

Project No: 100200.32

**ADDENDUM NO. 2
TO THE CONTRACT DOCUMENTS AND DRAWINGS**

**For the construction of the
Aloe Bay Water Quality Enhancement Wastewater Treatment Facility**

To All Planholders:

The following changes, additions, and/or deletions are hereby made a part of the Contract Documents and Drawings for the **Aloe Bay Water Quality Enhancement Wastewater Treatment Facility** project for Dauphin Island Water and Sewer Authority as fully and completely as if the same were set forth therein:

The Bid will be postponed to October 1st at 2:00 pm central. The questions cutoff date will be changed to September 24th at 4:00pm central time.

SPECIFICATIONS

1. Remove Specification 15111 – Pipe Heat Tracing and replace with attached specification 15111 – Pipe Heat Tracing.

DRAWINGS

1. Remove sheet I-5.0 and replace with revised sheet I-5.0
2. Remove sheet I-0.50 and replace with revised sheet I-0.50
3. Remove sheets M-4.0, M-4.1, M-4.2, M-6.0, M-6.4 and replace with revised sheets M-4.0, M-4.1, M-4.2, M-6.0, M-6.4

CLARIFICATIONS

1. Please confirm if this project is AIS

This project does not require compliance with American Iron and Steel (AIS).

2. The MCC cubicle (shown on drawing E-0.51) designated to provide power for the headworks compressor, shall be repurposed as a “Spare” instead of being dedicated for the “Headworks Air Compressor”.
3. The “P9” power feeder for the Headworks Air Compressor shown on drawing E-0.51 shall be omitted.

4. The two pole 20A circuit breaker allotted to provide power for the “Headworks Screen Air Compressor” from Panel LV (drawing E-0.70) shall be revised to be a spare and the “Headworks Screen Air Compressor” shall be relocated to one of the spare single pole 20A breakers.
5. The “Headworks Compressor” in the “MCC Load Schedule” on drawing E-0.73 shall be omitted.
6. The P9 power feeder (consisting of 3#12 and 1#12 G in a 1” conduit) shown on drawing E-3.0 “Mechanical Screen Air Compressor” shall be replaced with a P15 power feeder (consisting of 3#12 in a ¾” conduit). The associated disconnect switch shall be replaced with a weatherproof while-in-use GFI receptacle to provide power for the compressor.

ATTACHMENTS

1. Revised Sheet I-5.0
2. Revised Sheet I-0.50
3. Revised Sheets M-4.0, M-4.1, M-4.2, M-6.0, M-6.4
4. Markups to sheets E-0.51, E-0.70, E-0.73, E-3.0
5. Specification 15111 – Pipe Heat Tracing
6. Pre-bid Sign-in Sheet

REQUEST FOR EQUALS

1. BMC is an approved equal for laboratory fume hoods so long as the fume hood adheres to specification 11601 – Laboratory Fumehoods
2. ValMatic is an approved equal for all plug valves, check valves, and butterfly valves.
3. AvTek is an approved equal for all knife gate valves.
4. Amwell is an approved equal for all telescoping valves.
5. EDGENG is an approved equal for any FRP application so long as it adheres to Specification 11356 – Fiberglass Baffle Walls

QUESTIONS

1. Per the “Procurement of Recovered Materials” list of products, do we have to purchase these products manufactured of recycled materials?

See note N.04.10 in the RESTORE council standard terms and conditions. The contractor must procure materials with the highest percentage of recovered materials practicable.

2. Will the Owner allow the GC to tie-into existing Water and Power sources, without incurring any usage fees?

DIWSA will not charge any connection fees or usage fees for utilities. The contractor will be responsible for locating and making any connections to power and water.

3. The Piping Schedule in sect. 15110 note #3 says to insulate and heat trace all water pipe that is less than 6” dia. Deleting the heat tracing all together and only insulating 2” dia. and smaller seems more appropriate given the location. Please confirm whether this spec can be amended, and what the new requirement would be.

Heat tracing and insulation will be required for all pipes 6” diameter and less.

4. We only seem to have the 1st page of Sect. 15111, Pipe Heat Tracing. If heat tracing is still required, please provide the full spec.

Heat tracing is required. See the attached revised specification 15111 – Pipe Heat Tracing.

5. Will Ardurra provide an initial survey of all corners of structures?

Ardurra can provide the original topographic survey performed during design as well as the electronic CAD file for the survey. Any additional survey for new structures shall be performed by the contractor.

6. Is MH-1 the standard 4'-0" dia.? It appears to be larger than the other 4' manholes on sheet C-4.0.

MH-1 will be a 5'-0" diameter manhole.

7. Sheet L-1.0 does not indicate that the 16 Palm Trees are existing. Are they to be new or remain as existing?

The palm trees seen on Sheet L-1.0 are existing and shall be protected during construction.

8. Does the PEMB at the CCB require any insulation at the walls or ceiling?

The PEMB at the chlorine contact basin will not require any insulation in the walls or ceiling. The PEMB at the dewatering facility WILL require insulation in both the walls and the ceiling, as specified.

9. Is the demo of the existing "barn", at the northeast corner of the site, to be included in the Base Bid?

The demolition of the barn shall be included in the base-bid.

10. Please specify the Launder Coating material, noted on sheet M-3.3. We've had Sprayroq specified many times before. This could also be utilized at the new MH-1 and the existing SMH-2.

Launder coating material is provided in Specification 09900 – Painting, section 3.10.C

11. On the roof of both PEMB's, 1 1/4" is referenced for the depth. Is this for standing seam metal or R-panel?

The roof panels should match the operations building as specified in Section 07411 – Metal Roof Panels. The 1-1/4" depth should only reference the PEMB side panel profile.

12. What is the location of the monorail at the Dewatering Bldg? Does it travel back and forth in the building?

Monorail shall be installed on the centerline of the screw press and extend from wall to wall (north to south). Coordinate attachments with the PEMB supplier to provide the maximum available travel between the two walls.

13. Please specify the thickness of the PVC wall liner panels in the Dewatering Bldg.

Section 13121 – Pre-Engineered Metal Buildings paragraph 2.08 Interior Liner Panels, E. Thickness 0.039"

14. The electrical specs state no EMT allowed. Can we amend this statement to state EMT is only allowed in interior Operations building enclosed in ceilings, walls?

EMT is allowed in the interior operations building enclosed in ceilings and walls.

15. In the structural S-9.3, this wall is shown as 8" CMU. Please clarify if it's 8" or 12".
The wall is an 8" CMU.

16. Clarifications to Specification 11542 – Screw Press

- 1.03 Please provide section 16150 as we were not able to locate this item in the full specification package. **Section 11542 – Screw press, 1.03 submittals, paragraph G, Remove sentence: "Include motor data as required by Section 16150"**

- 1.02 Please list In-Line Grinder as optional equipment from dewatering manufacturer as wedge wire basket systems that use wipers and brushes do not require in-line grinders. **An In-line grinder will be required. No Exception.**

- 1.01.2 Confirm 331 lbs/hr is the correct solids throughput for sludge with a concentration of 0.5-2.0%.

Solids to Dewatering based on 5 days/week: 1,987 lb/day

Solids to Dewatering based on 30 hr/week operation: 331 lb/hr

With digester percent solids at 1.0%-1.5%, the hydraulic loading to the screw press: 3,960-2,648 gal/hr (66-44 gpm)


- 2.03.C Please list rotary drum thickener and drum Transfer pump as "if applicable", as this is not required for all screw press applications. **The rotary Drum Thickener and drum transfer pump is required for this installation. No Exception.**

- 2.09 Please list the Equipment skid as "if applicable", as this is the only needed by screw presses that include integrated thickener units and not necessary for screw press systems that can be inspected without a platform **Integrated thickener and associated equipment skid is required. No Exception.**

Sheet M-6.2 Please confirm number of screw conveyors for dewatered cake. It appears as there is three (a smaller cake transport conveyor connected to the discharge end of the screw press, the inclined transfer conveyor, and the distribution conveyor)

Three screw press conveyors will be required. No Exception.

Ardurra,

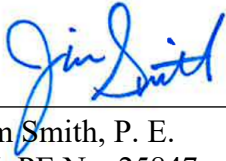

Jim Smith, P. E.
AL PE No. 25847

All Bidders shall acknowledge receipt and acceptance of the Addendum with the Bid Package. Proposals submitted without acknowledgement or without this Addendum will be considered informal.

Receipt acknowledged and conditions agreed to this _____ day of _____, 2024.





Bidder

By




RELEASE FOR BID




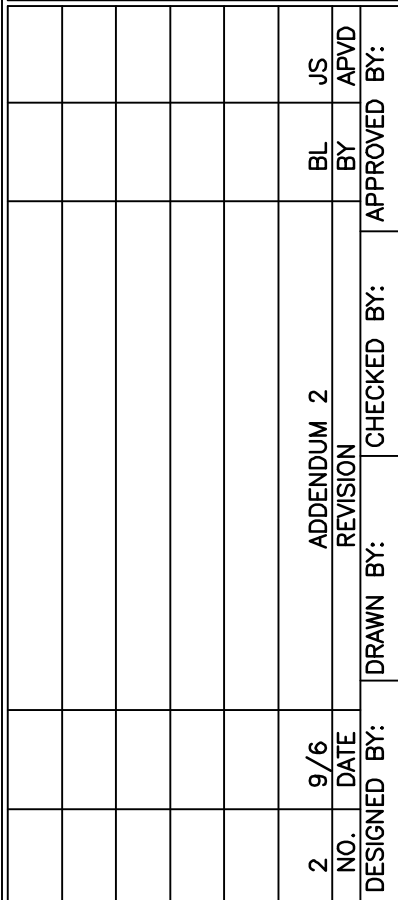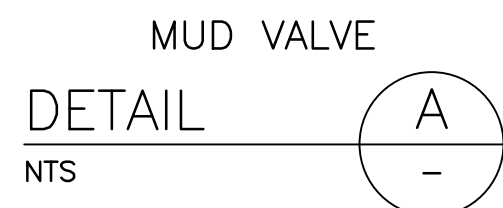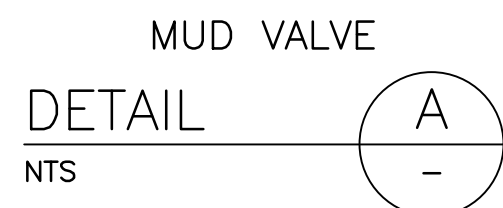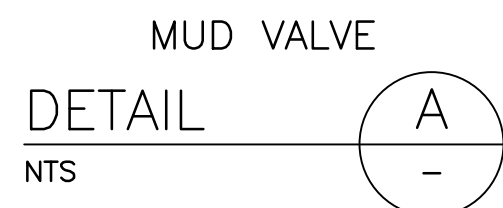

Dolphin Island

Susan and Martin Armstrong

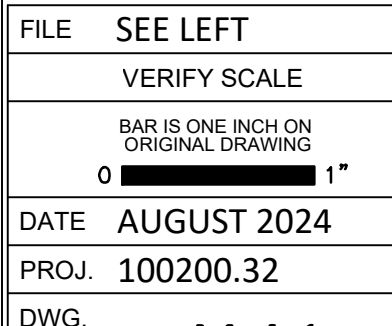

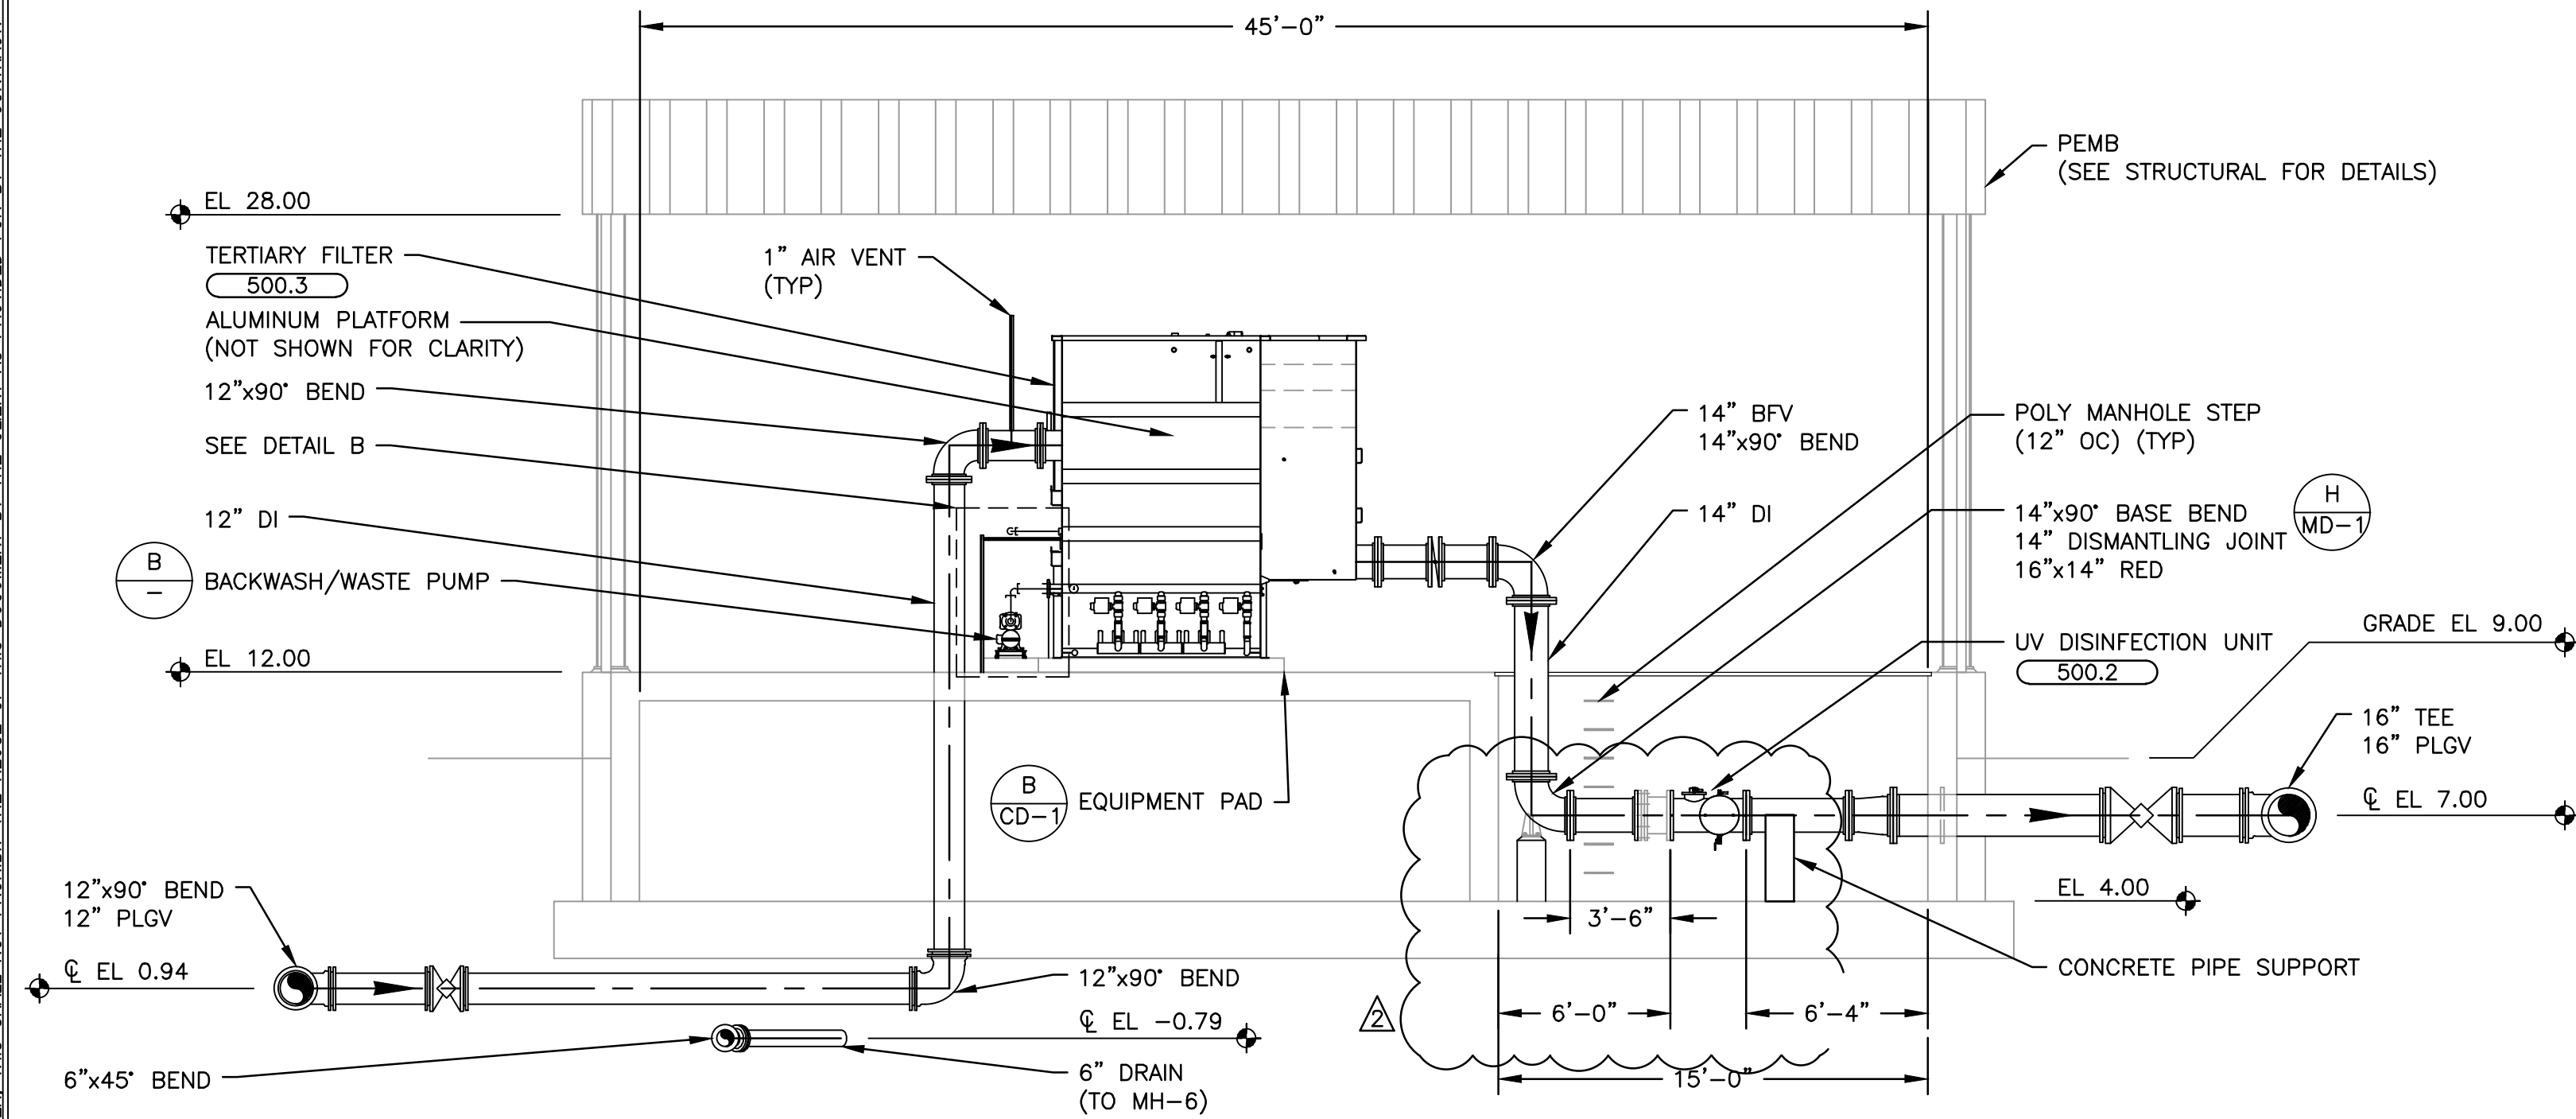

SECTION


$3/16" = 1'-0"$

3

M-4.0

0 4 8

GRAPHIC SCALE

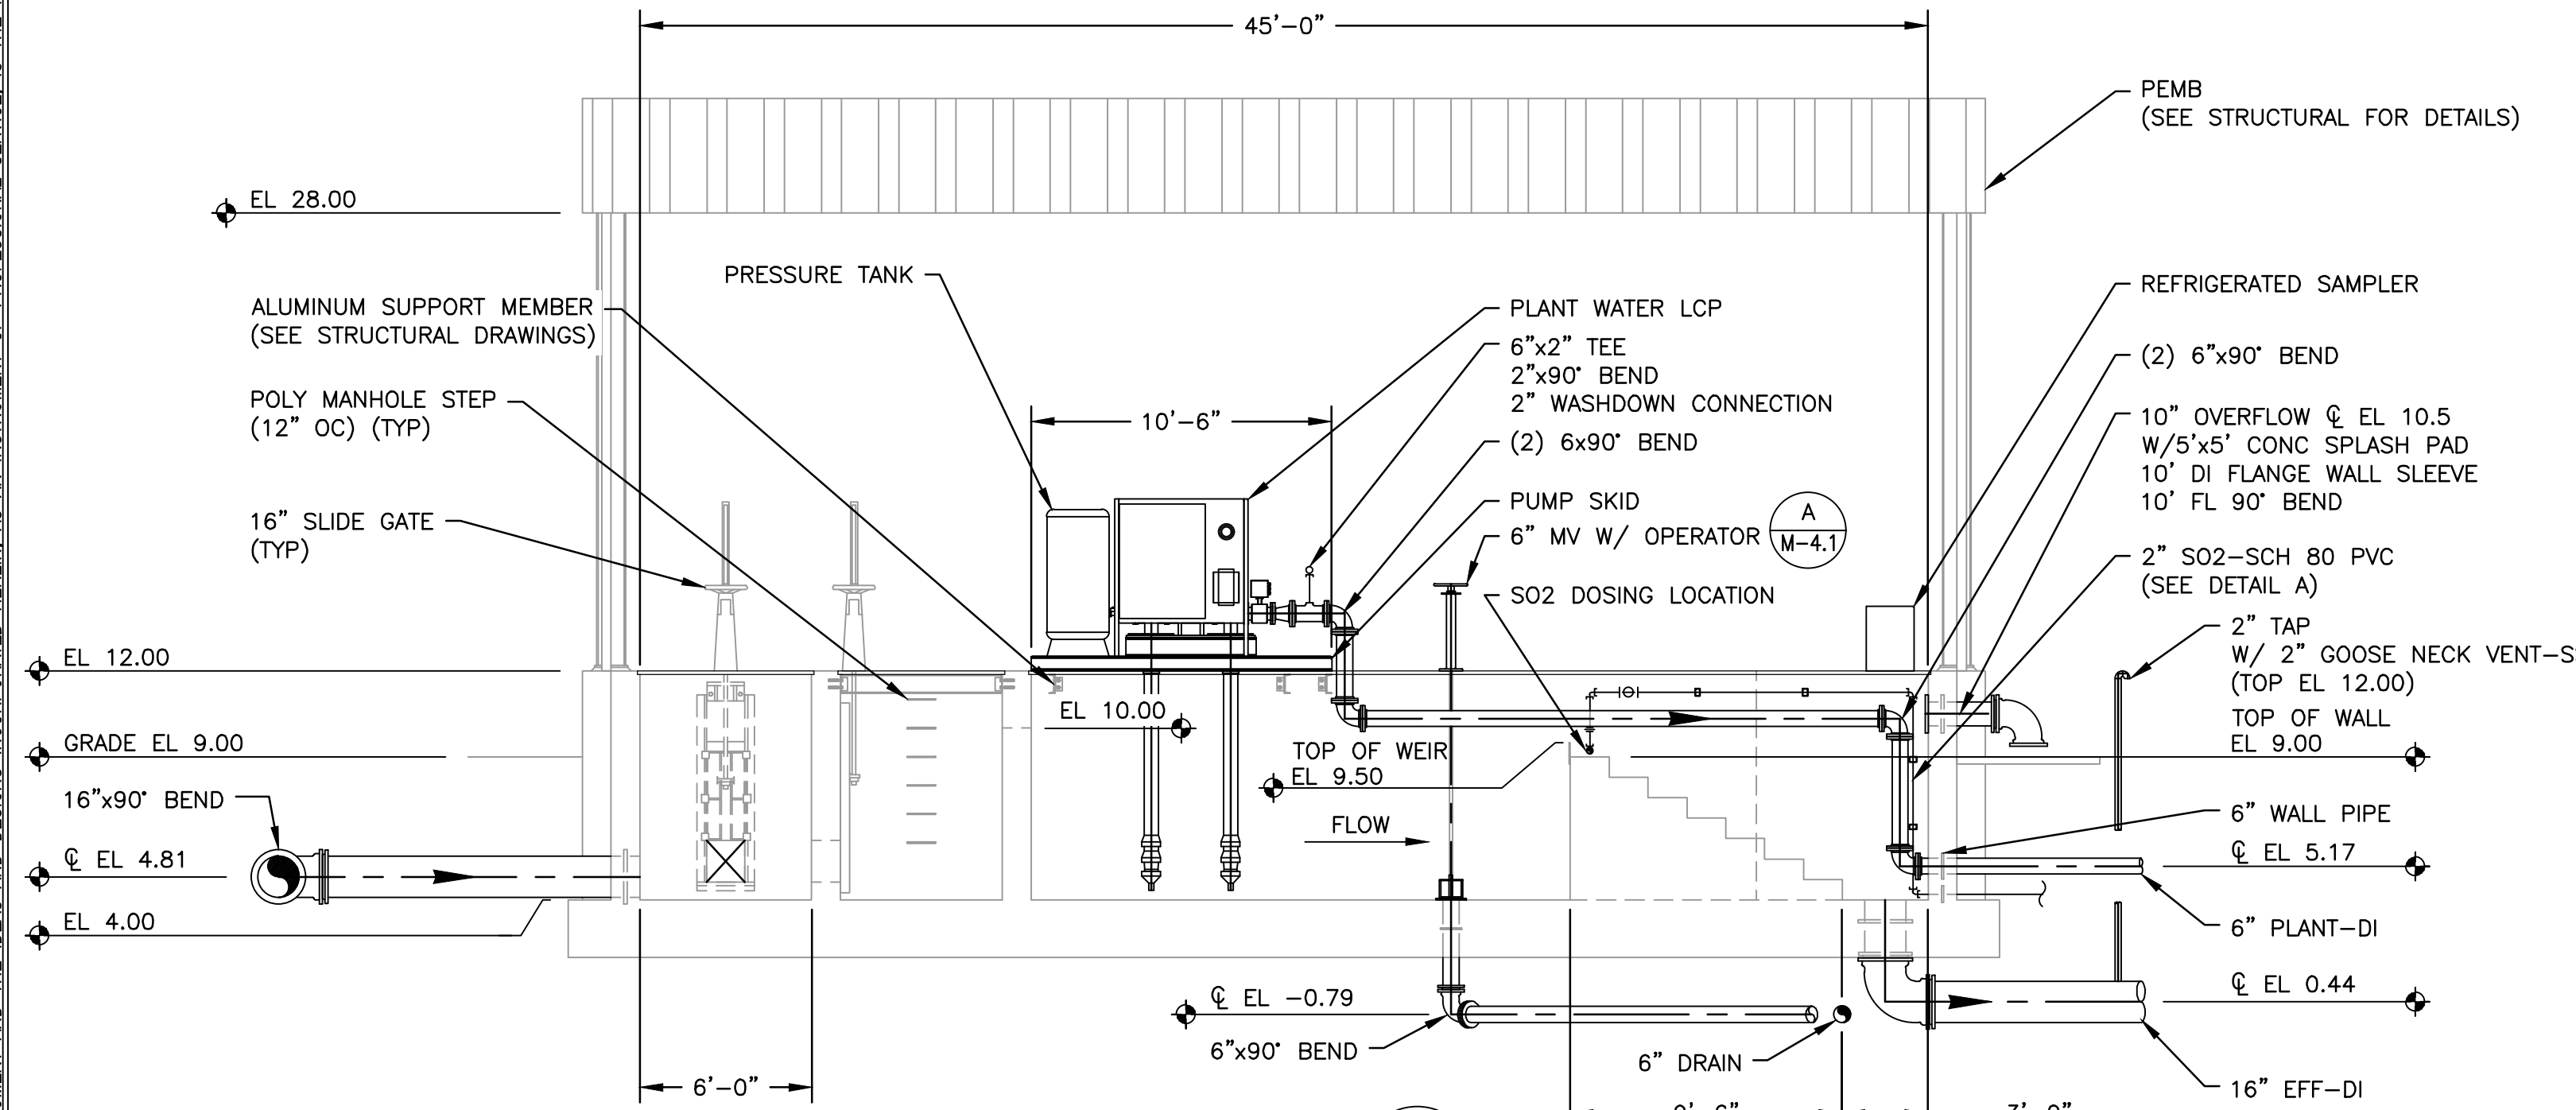

SECTION



$3/16" = 1'-0"$

4

M-4.0

0 4 8

GRAPHIC SCALE

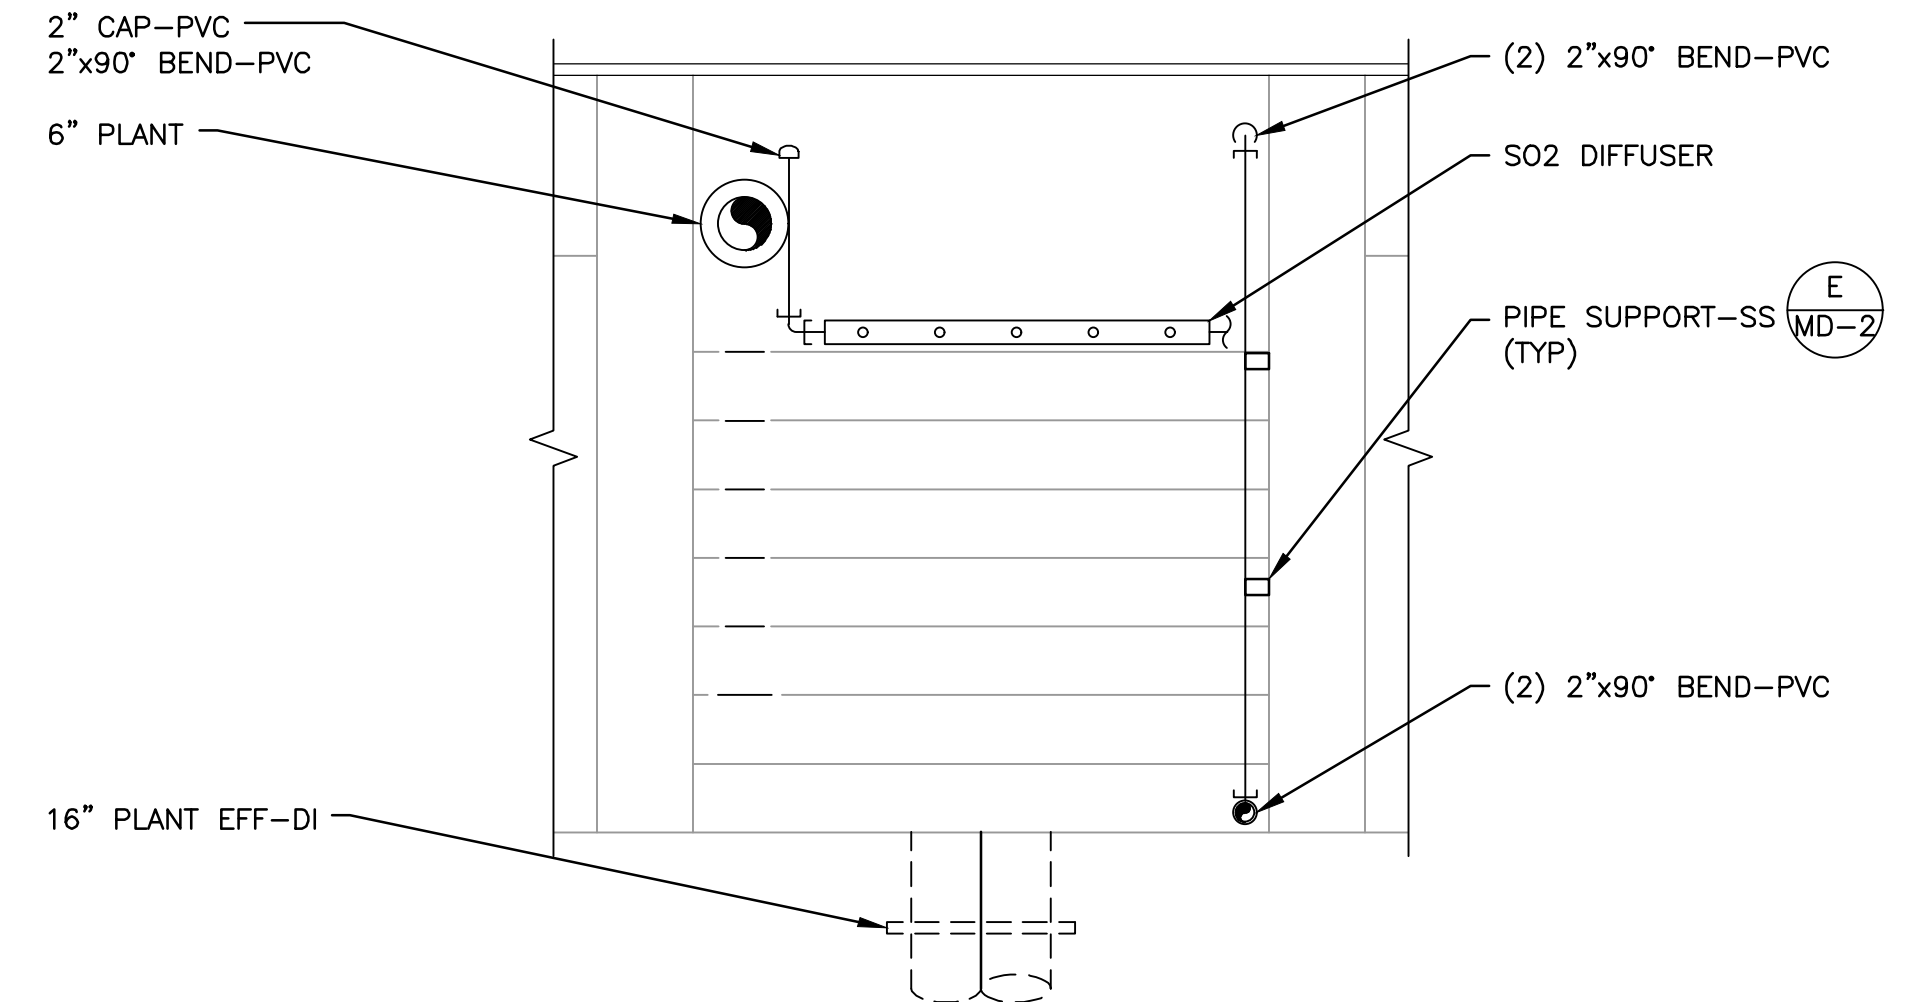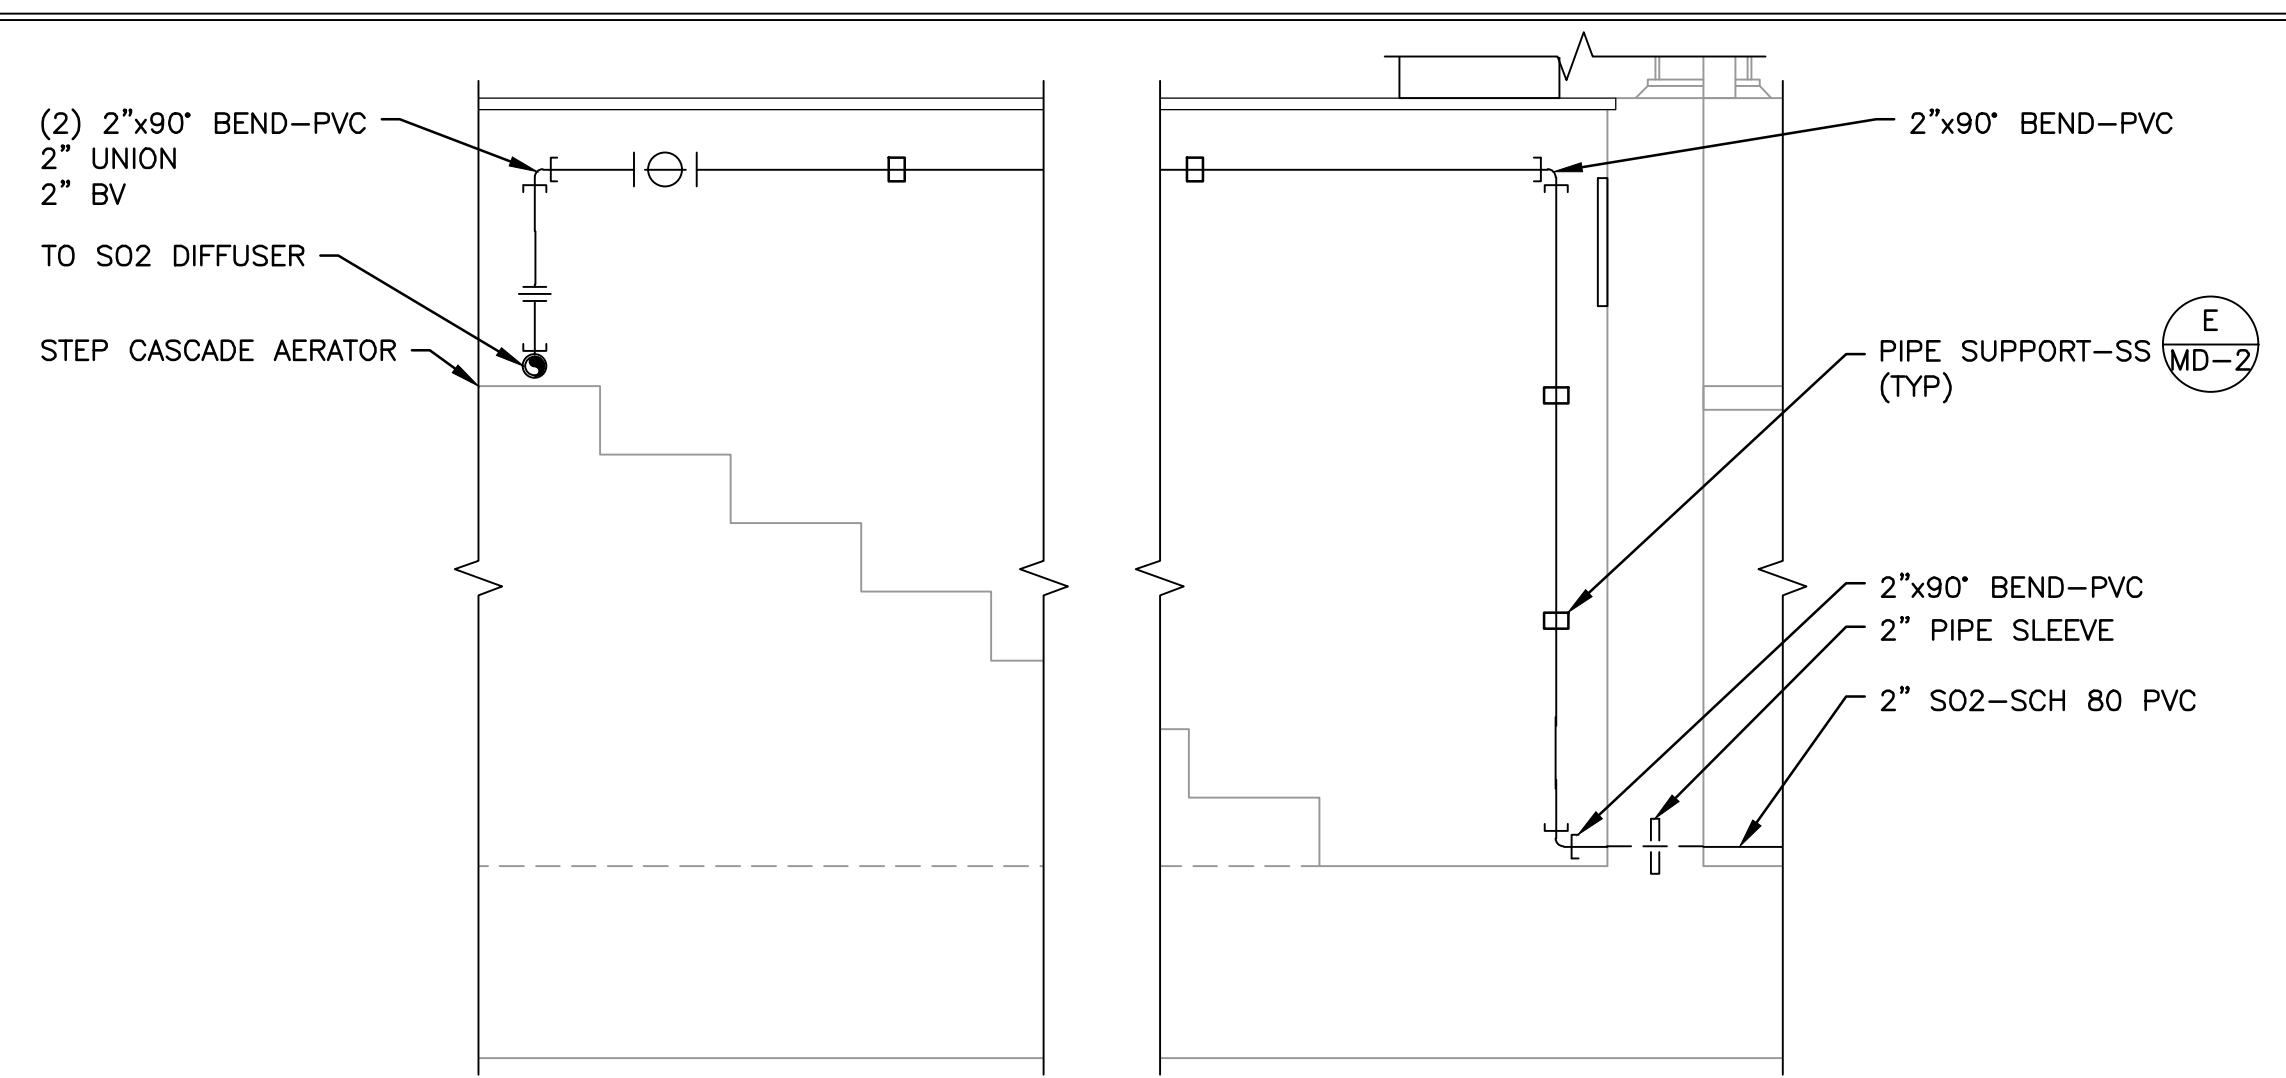


SO2 DIFFUSER

DETAIL

NTS

A

-

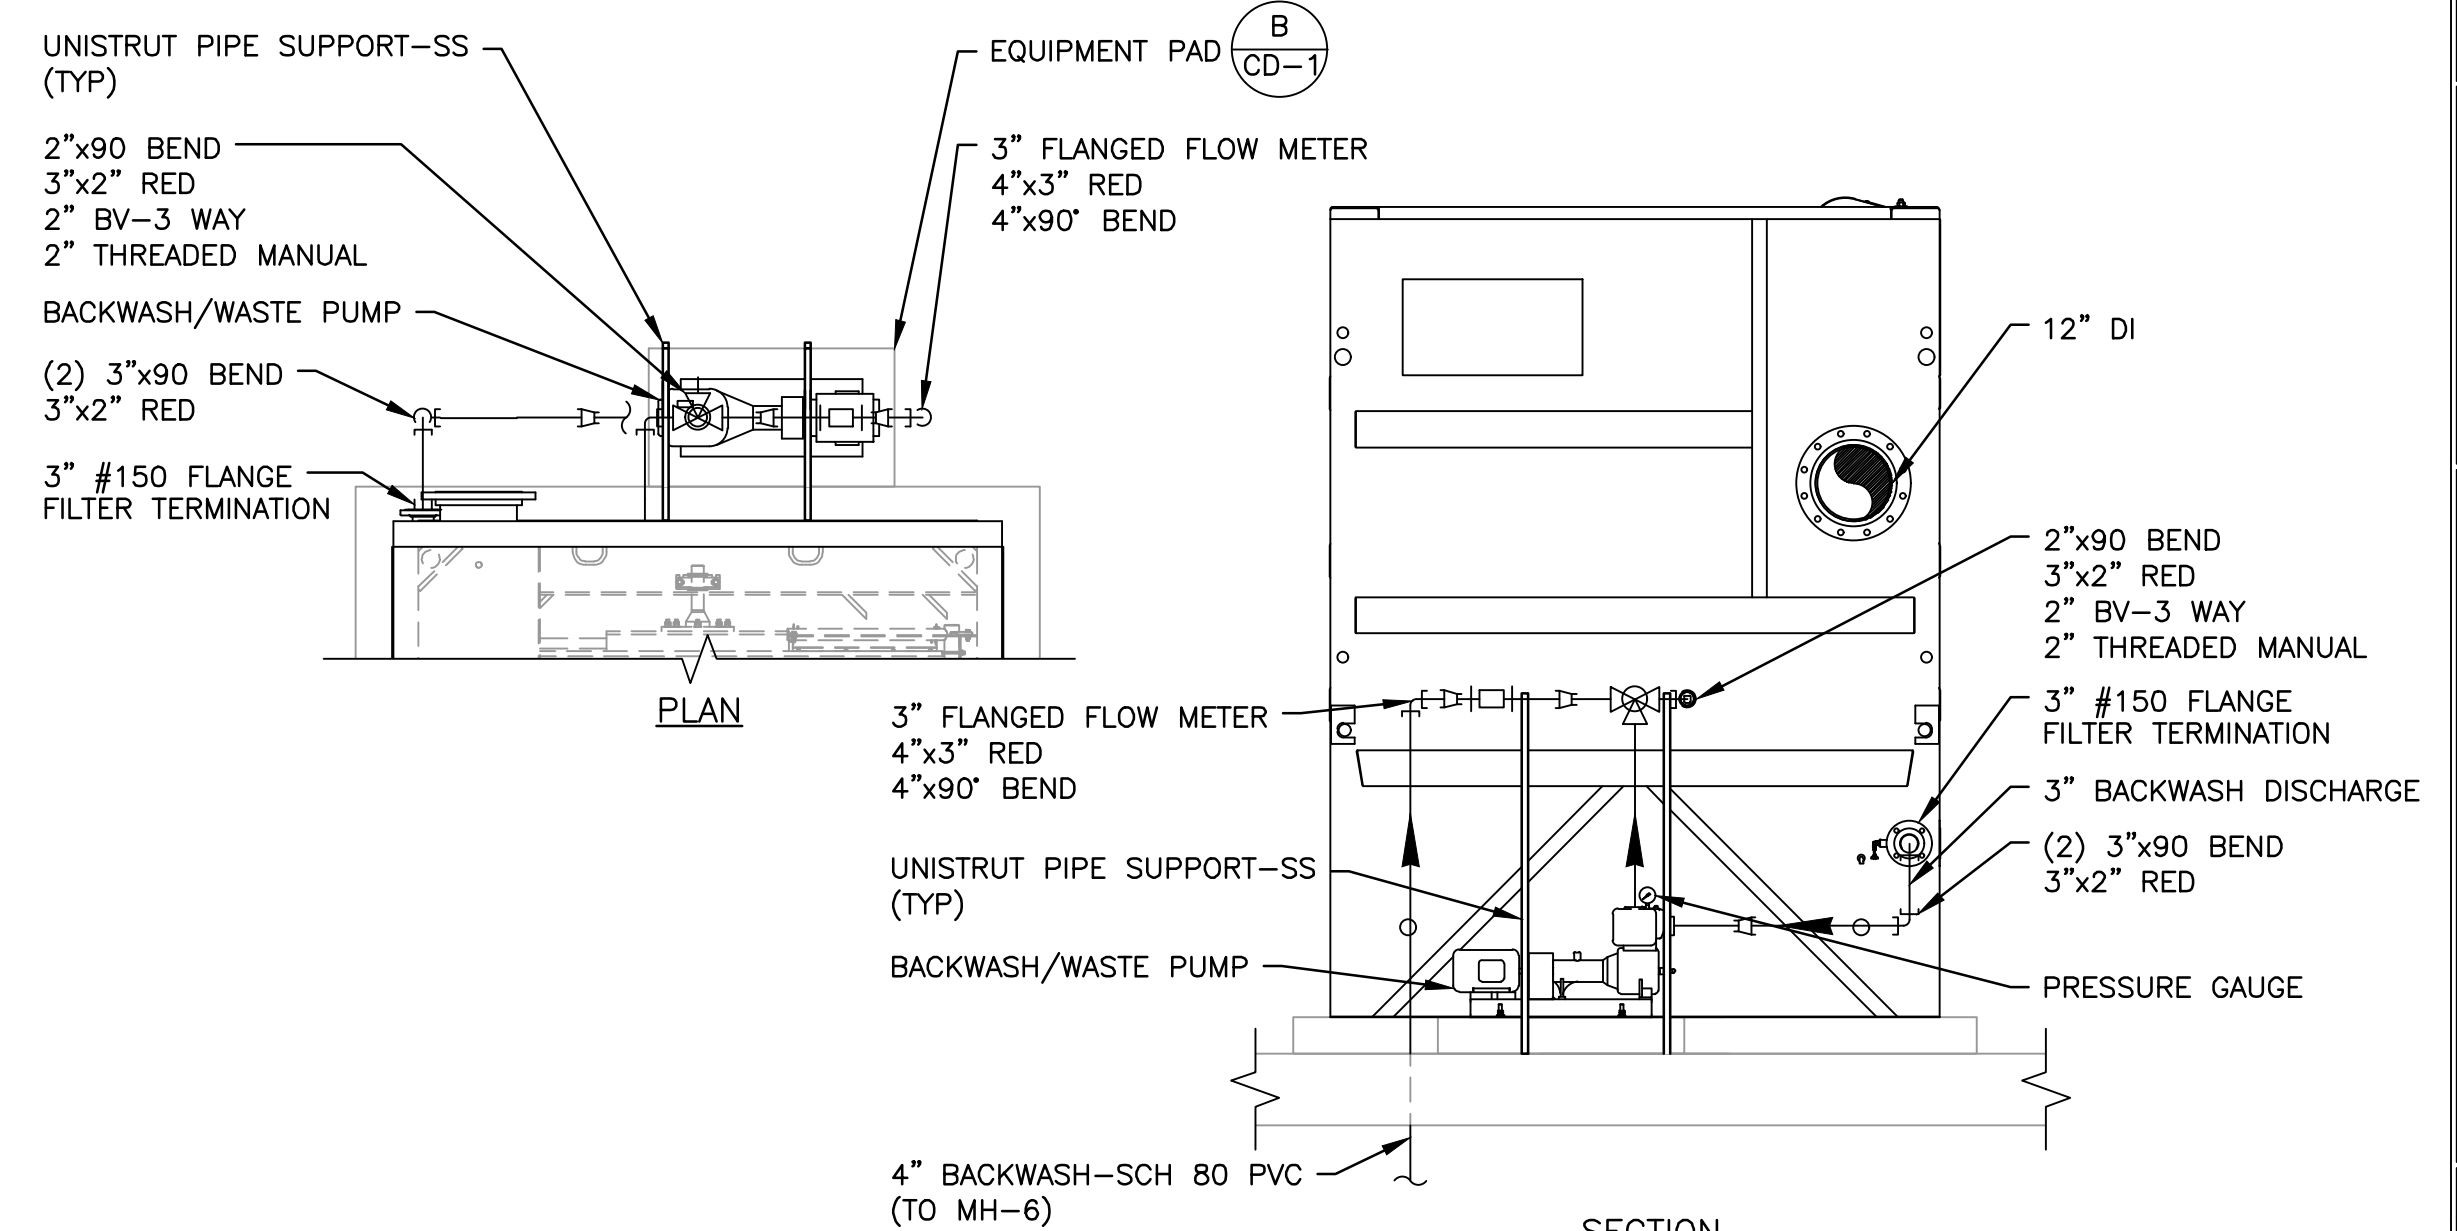

BACKWASH/WASTE PUMP
DETAIL
NTS



2	9/6	ADDENDUM 2	BL	JS
DESIGNED BY:	DATE	REVISION	APPROVED BY:	APPROVED BY:
BL		DRAWN BY:	JS	
		LR	SC	


CHLORINE CONTACT BASIN SECTIONS



FILE SEE LEFT

VERIFY SCALE


BAR IS ONE INCH ON
ORIGINAL DRAWING

0  1"

DATE AUGUST 2024

PROJ. 100200.32

WG. M 4 3

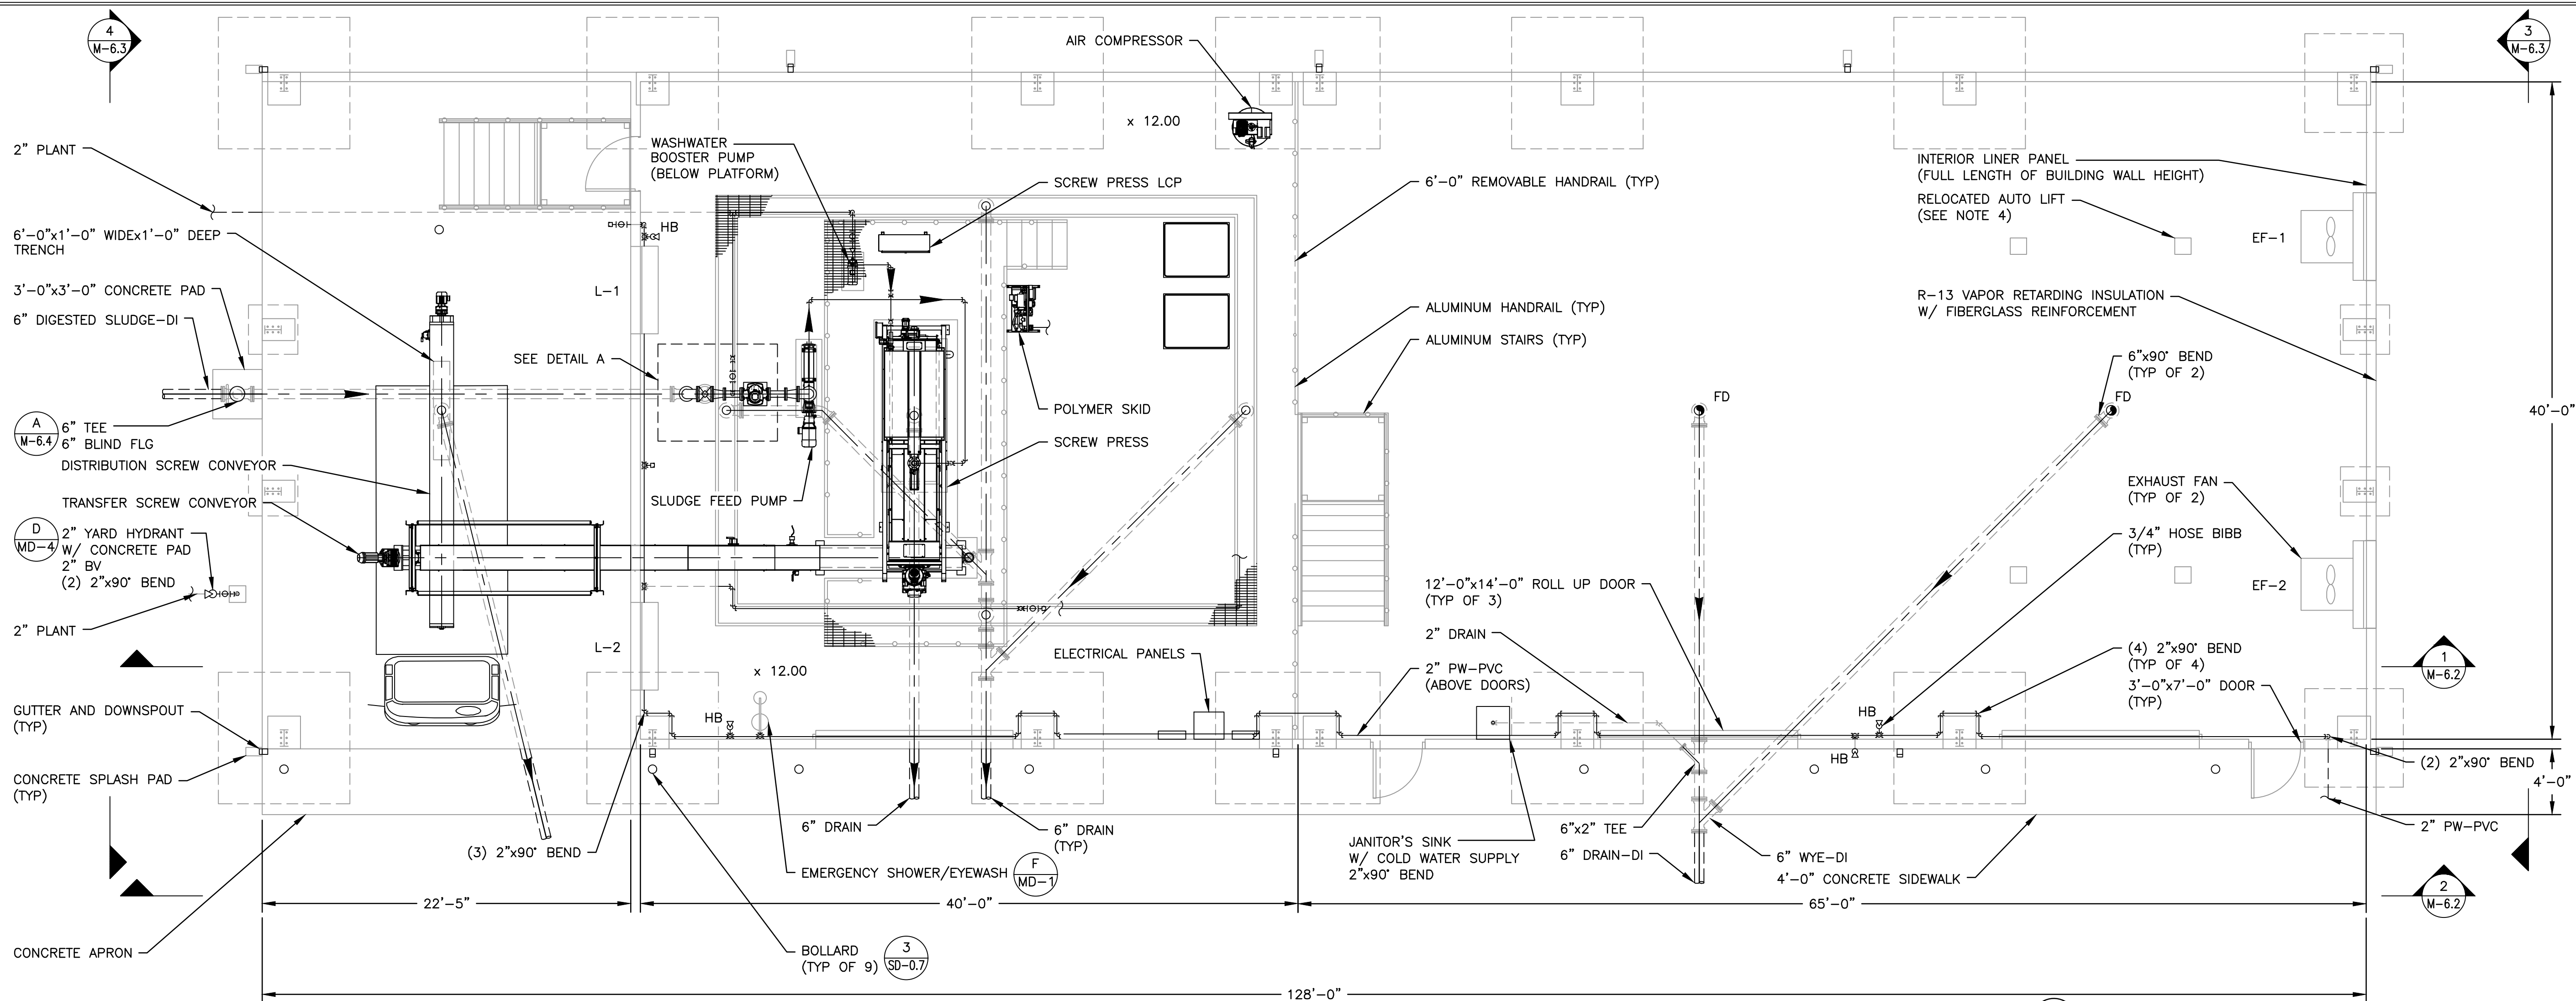

FAN SCHEDULE														
MARK	LOCATION	SERVING	FAN TYPE	BLADE TYPE	DRIVE	CFM	HP	RPM	SP (IN)	SONES	VOLT/PH	BASIS OF DESIGN		ACCESSORIES
												MANUFACTURER	MODEL	
EF-1	HIGH ON EXTERIOR WALL	DEWATERING BUILDING	PACKAGED WALL FAN	PROP	BELT	9,200	1.0	490	0.125	14.4	460/3	COOK	42P7B	1, 2, 3, 4
EF-2	HIGH ON EXTERIOR WALL	DEWATERING BUILDING	PACKAGED WALL FAN	PROP	BELT	9,200	1.0	490	0.125	14.4	460/3	COOK	42P7B	1, 2, 3, 4

ACCESSORIES:

1. PROVIDE OSHA WIRE GUARD.
2. PROVIDE WALL COLLAR.
3. PROVIDE MOTORIZED DISCHARGE WALL SHUTTER.
4. ENTIRE ASSEMBLY SHALL HAVE BAKED ENAMEL FINISH TO MATCH COLOR SELECTED BY ARCHITECT/ENGINEER.


LOUVER SCHEDULE											
MARK	FUNCTION	SIZE	CFM	FREE AREA (SF)	CONSTRUCTION	FRAME TYPE	FINISH	BASIS OF DESIGN	MODEL	OPTIONS	NOTES
L-1	INTAKE FOR EF-1	48"x72"x4"	9,200	13.13	0.125" EXTENDED ALUMINUM	FLANGE	KYNAR	RUSKIN	ELF375DXH	1, 2, 3, 4	1
L-2	INTAKE FOR EF-2	48"x72"x4"	9,200	13.13	0.125" EXTENDED ALUMINUM	FLANGE	KYNAR	RUSKIN	ELF375DXH	1, 2, 3, 4	1

OPTIONS:

1. PROVIDE 1/4"x1/4" WELDED WIRE MESH SCREEN IN REMOVABLE FRAME.
2. PROVIDE KYNAR FINISH. SUBMIT COLOR CHART FOR ARCHITECT/ENGINEER TO SELECT COLOR.
3. PROVIDE SPRING RETURN MOTORIZED ACTUATOR AND LOW LEAK OPPOSED BLADE DAMPER.
4. PROVIDE SECURITY BARS IN LOUVER ASSEMBLY.

NOTES:

1. RUSKIN HAS BEEN SPECIFIED TO ESTABLISH THE TYPE AND QUALITY OF LOUVER TO BE INSTALLED. EQUAL LOUVERS BY GREENHECK OR AMERICAN WARMING AND VENTILATING WILL BE CONSIDERED.

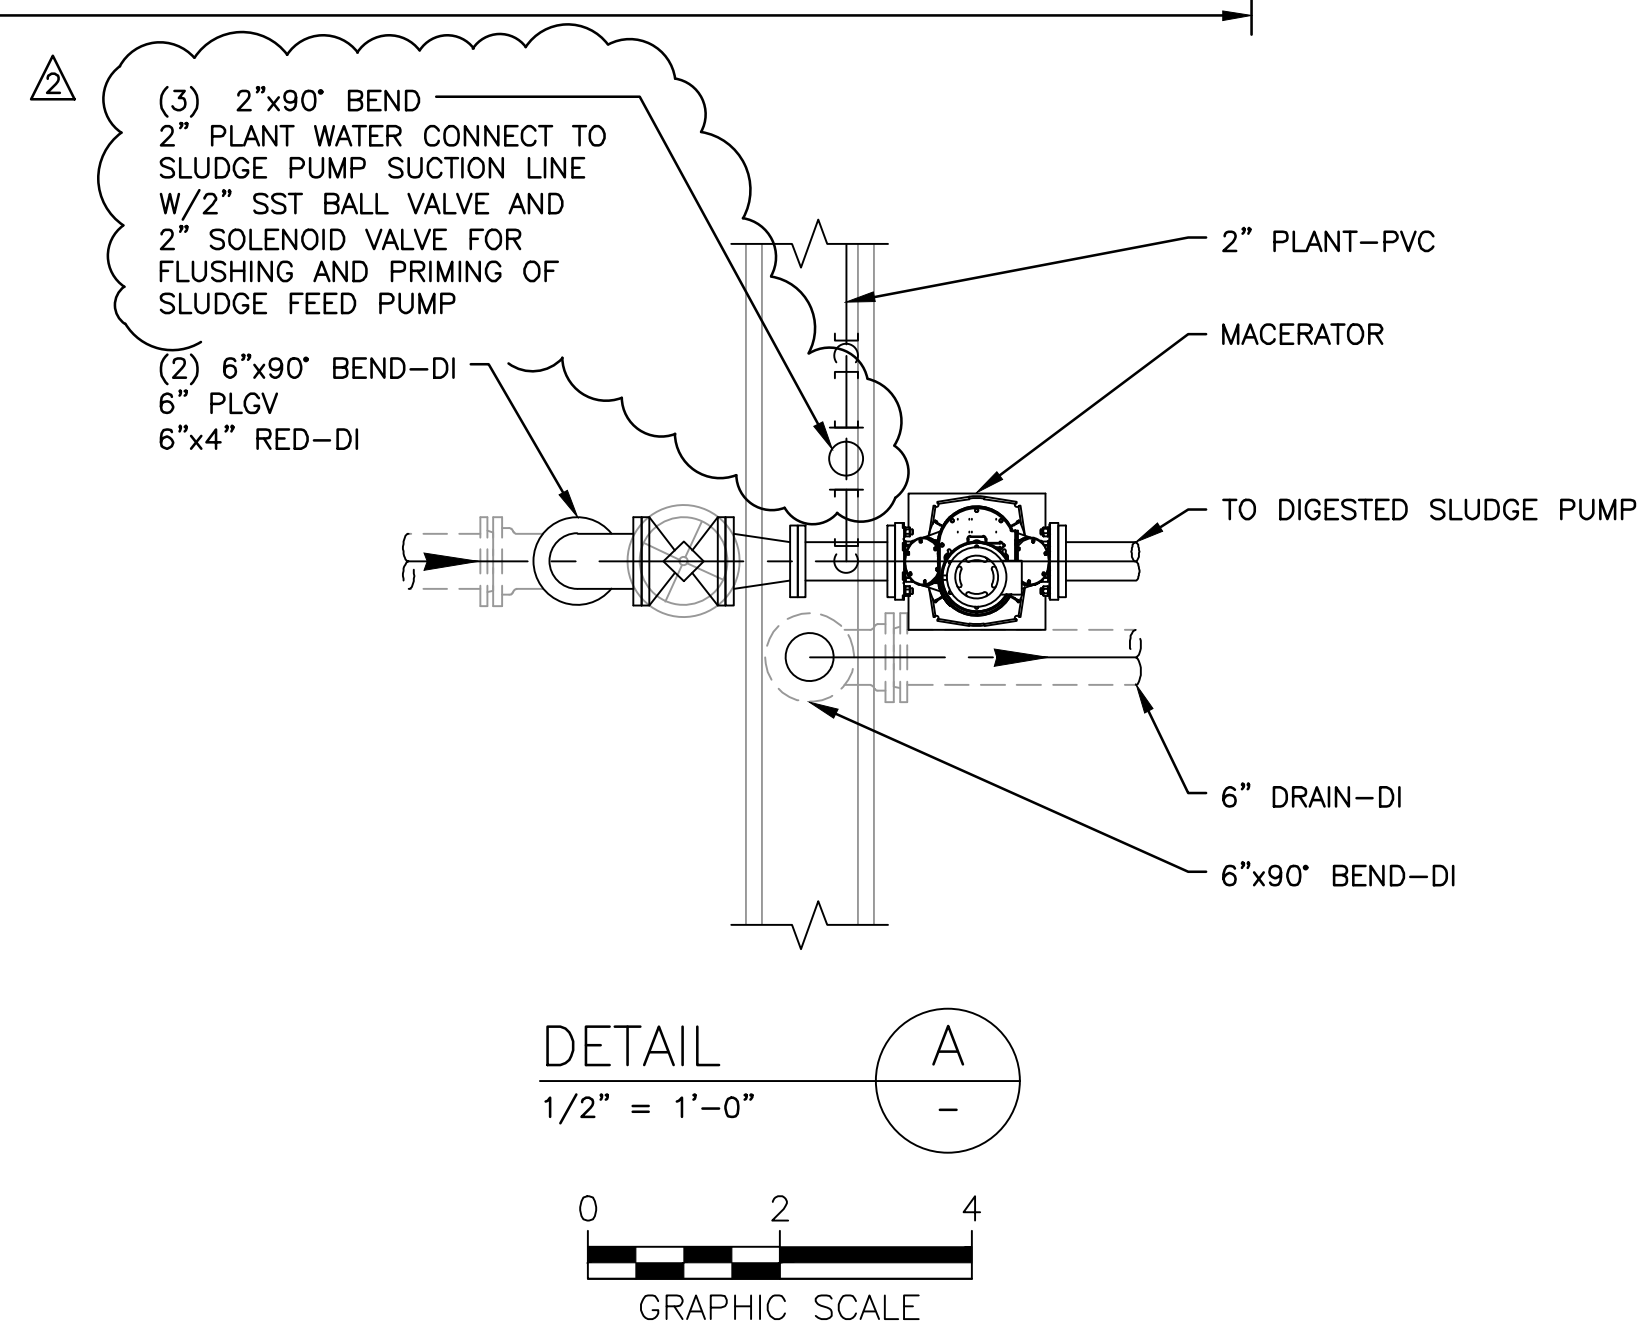

NOTES:


1. 2" HOSE BIBB SHALL BE STAINLESS STEEL FIRE HOSE QUICK CONNECT (FEMALE).
2. PROVIDE 50' OF 2" SINGLE JACKET MILL HOSE AND HOSE RACK AT EACH 2" HOSE BIBB LOCATION. PROVIDE 2" STAINLESS STEEL QUICK CONNECT (MALE).
3. ALL DRAINS IN DEWATERING BUILDING SHALL HAVE P-TRAPS.
4. INSTALL OWNER PROVIDED ANCHORS FOR AUTO LIFT. RELOCATE LIFT FROM OLD MAINTENANCE BUILDING TO SPECIFIED LOCATION.
5. ROUTE 2" PW OVER DOORS AND UNDER ELECTRIC PANELS.


RELEASE FOR BID


[illegible]



DEWATERING BUILDING SERVICES PLAN AND DETAIL

MODE BAY WATER QUALITY ENHANCEMENT WASTEWATER TREATMENT FACILITY

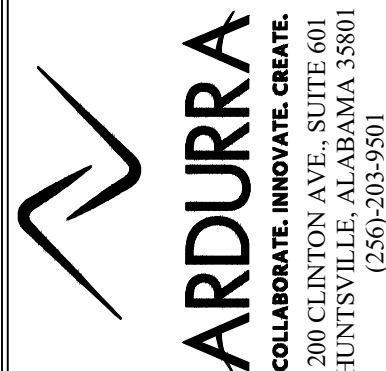


FILE	SEE LEFT
	VERIFY SCALE
	BAR IS ONE INCH ON ORIGINAL DRAWING
	0  1"
DATE	AUGUST 2024
PROJ.	100200.32
DWG.	M 6 0

FILE	SEE LEFT
	VERIFY SCALE
	BAR IS ONE INCH ON ORIGINAL DRAWING
	0  1"
DATE	AUGUST 2024
PROJ.	100200.32
DWG.	M 6 4

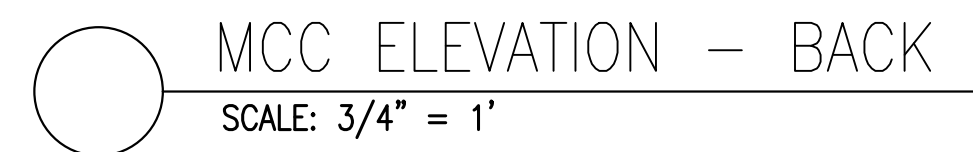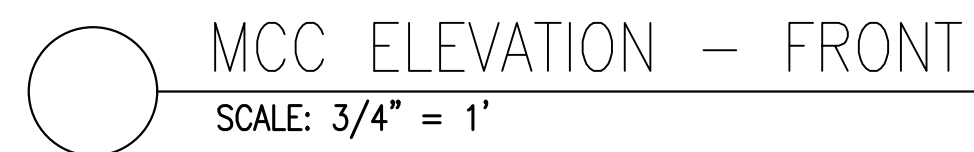[illegible]


ALOE BAY WATER QUALITY ENHANCEMENT WASTEWATER TREATMENT FACILITY





LE	SEE LEFT
	VERIFY SCALE
	BAR IS ONE INCH ON ORIGINAL DRAWING
	0  1"
DATE	AUGUST 2024
PROJ.	100200.32
WG.	5 0 5 1

PANEL HV SCHEDULE
SCALE: NONE

PANEL LV SCHEDULE
SCALE: NONE

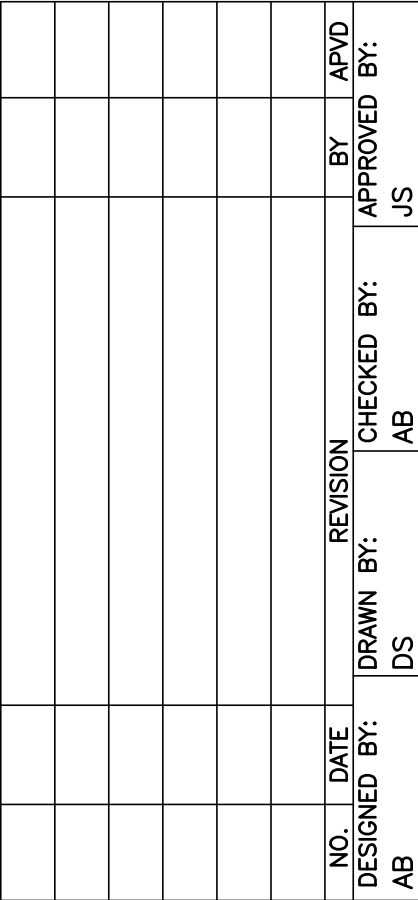

ALOEBAY WATER QUALITY ENHANCEMENT WASTEWATER TREATMENT FACILITY

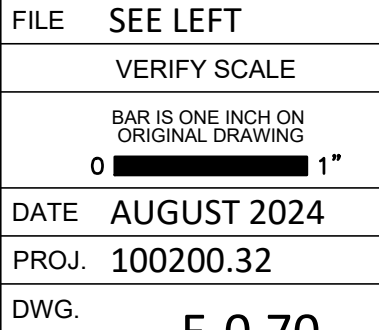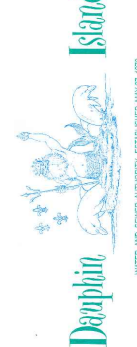


MCC LOAD SCHEDULE

SCALE: NONE


POWER CONDUIT AND CONDUCTOR SCHEDULE

CONTROL CONDUIT AND CONDUCTOR SCHEDULE
SCALE: NONE

○ FIXTURE SCHEDULE

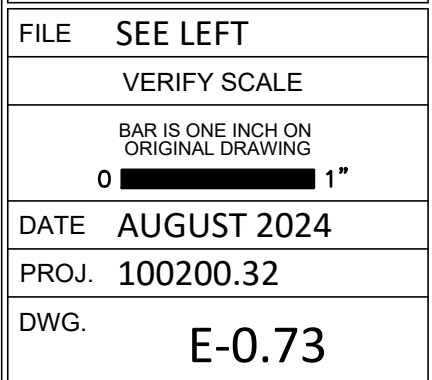

V:\PROJECT FILES\100200 - DAUPHIN ISLAND WATER & SEWER AUTHORITY\100200.32 - WWTU UPGRADES\300 DESIGN\355 PRELIMINARY DRAWINGS\07 ELECTRICAL\01 CADD\HEADWORKS.DWG
Daniel Stevenson PLOT 8/13/2024 8:40 AM SAVED 8/9/2024 3:25 PM
REUSE OF DOCUMENTS: THIS DOCUMENT AND THE IDEAS AND DESIGNS INCORPORATED HEREIN, AS AN INSTRUMENT OF PROFESSIONAL SERVICE, IS THE PROPERTY OF CONSTANTINE ENGINEERING. HOWEVER, THIS SHALL NOT PROHIBIT THE REUSE OF THIS DOCUMENT BY THE CLIENT AS PROVIDED FOR BY THE CONTRACT.

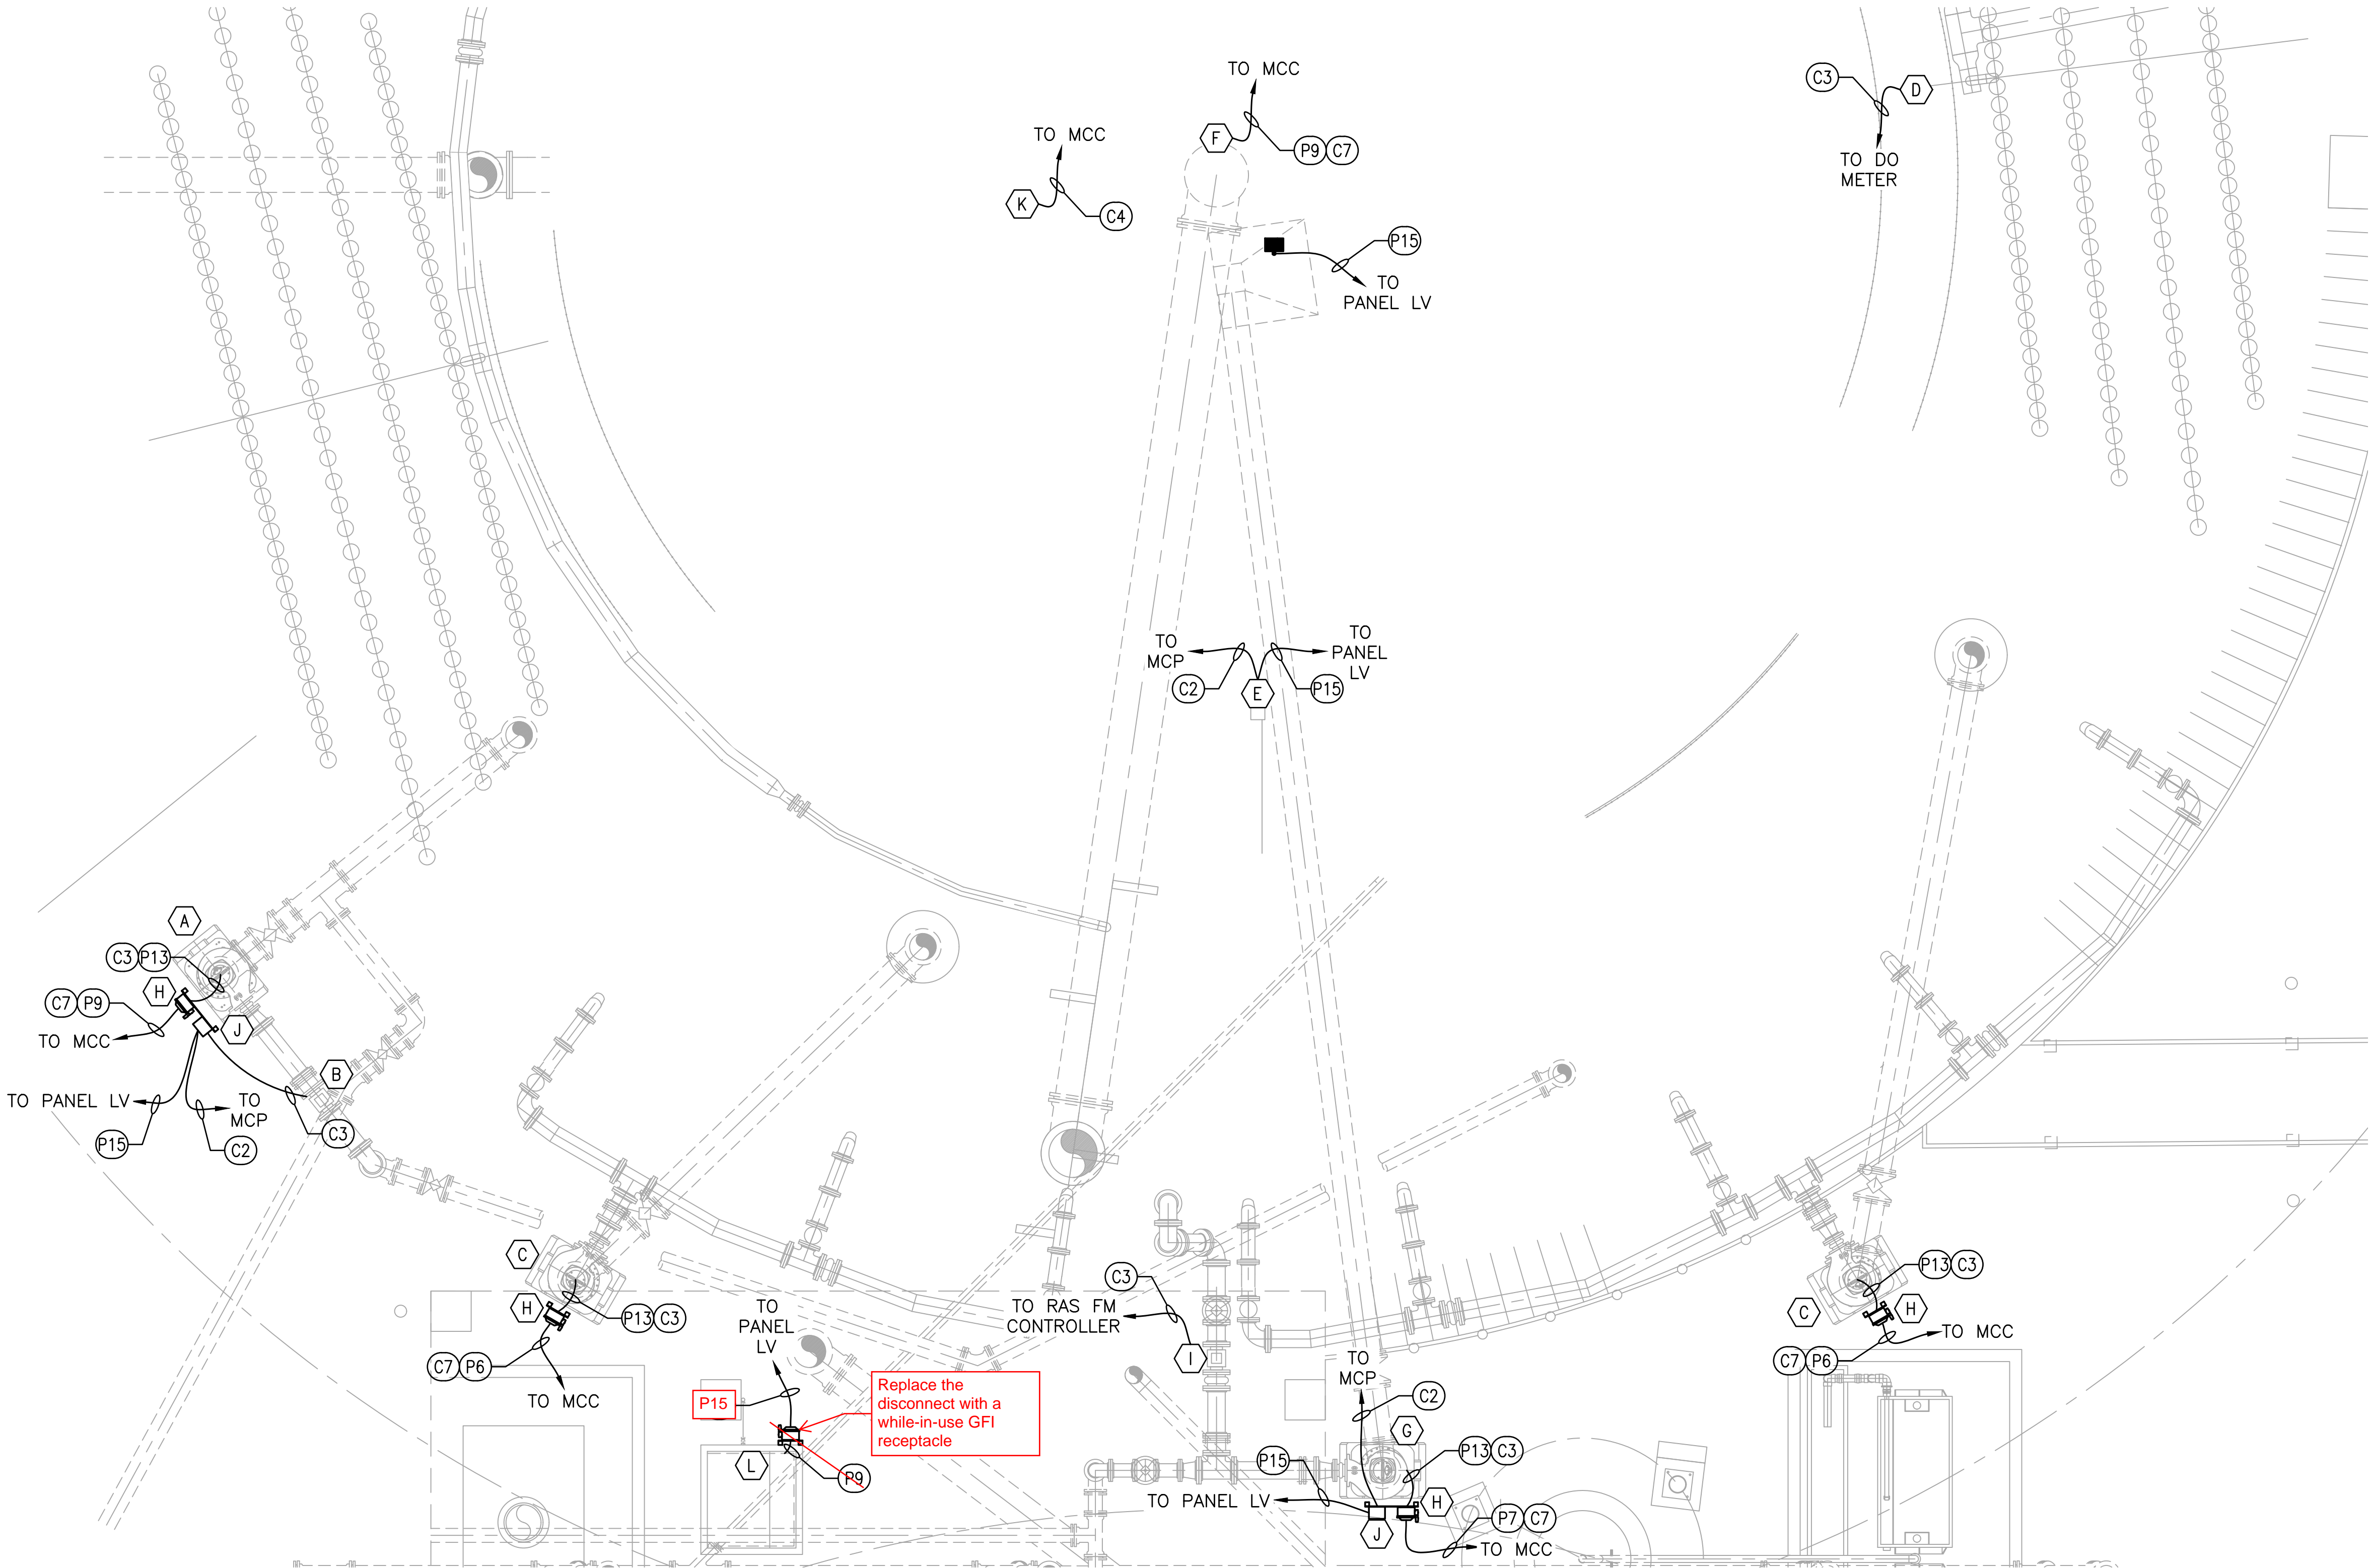



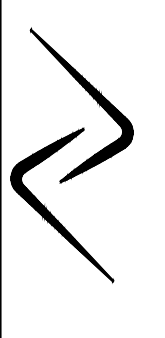
 NORTH PROCESS BASIN ELECTRICAL SITE PLAN
SCALE: 1/4" = 1'

GENERAL NOTES:

1. ALL ELECTRICAL PANELS (DISCONNECTS, CONTROL PANELS, ETC.) SHALL BE MOUNTED SO THAT THE BOTTOM OF THE PANEL IS NO LOWER THAN ELEVATION 12' TO KEEP THE EQUIPMENT OUT OF THE FLOOD PLAIN. FOR THIS AREA, THAT WILL RESULT IN THE BOTTOM OF THE EQUIPMENT BEING APPROXIMATELY 5' ABOVE GRADE. FOR DISCONNECT SWITCHES AND/OR DISCONNECT HANDLES, THE HANDLE SHALL BE NO HIGHER THAN 6'7" ABOVE FINISHED GRADE OR PLATFORM. IF NECESSARY, PLATFORMS SHALL BE PROVIDED TO ALLOW THE EQUIPMENT TO REMAIN OUT OF THE FLOOD PLAIN WHILE ALSO NOT EXCEEDING A HEIGHT OF 6'7" ABOVE GRADE OR THE WORKING PLATFORM.

KEY NOTES:

- (A) NRCY PUMP
- (B) NRCY FLOW METER.
- (C) MIXING PUMP. TYPICAL OF 2
- (D) DISSOLVED OXYGEN PROBE
- (E) DISSOLVED OXYGEN METER. SHALL BE MOUNTED TO A STAINLESS STEEL UNISTRUT EQUIPMENT RACK AND PROVIDED WITH A SUNSHIELD.
- (F) CLARIFIER MOTOR & TORQUE SWITCH JUNCTION BOX
- (G) RAS PUMP
- (H) MOTOR DISCONNECT WITH 3 POSITION HOA SWITCH AND 30MM RUNNING PILOT LIGHT. SHALL BE A NEMA 4X SS UNIT MOUNTED TO A STAINLESS STEEL UNISTRUT EQUIPMENT RACK. SEE DISCONNECT DETAIL ON DRAWING E-1.0. SHALL BE MOUNTED ABOVE THE REQUIRED FLOOD ELEVATION BUT THE FINAL ELEVATION OF THE HANDLE SHALL NOT BE GREATER THAN ALLOWED BY THE NEC.
- (I) RAS FLOW METER
- (J) FLOW METER CONTROLLER (TYP. OF 2). SHALL BE PROVIDED WITH SUNSHIELD.
- (K) CLARIFIER SPRAY SOLENOID
- (L) MECHANICAL SCREEN AIR COMPRESSOR

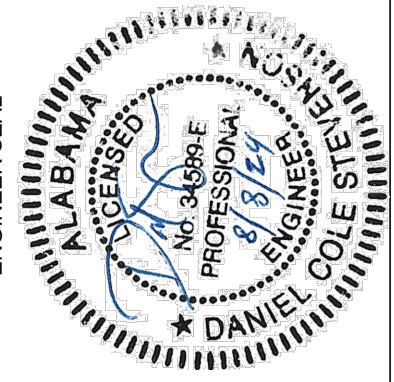	
ENGINEER SEAL	
NORTH PROCESS BASIN	
ALOE BAY WATER QUALITY ENHANCEMENT WASTEWATER TREATMENT FACILITY	
	
 ARDURRA COLLABORATE. INNOVATE. CREATE. 200 CLINTON AVE., SUITE 601 HUNTSVILLE, ALABAMA 35801 (256) 203-9501	
FILE	SEE LEFT
VERIFY SCALE	
BAR IS ONE INCH ON ORIGINAL DRAWING	
0 1"	
DATE	AUGUST 2024
PROJ.	100200.32
DWG.	E-3.0

RELEASE FOR BID

SECTION 15111 PIPE HEAT TRACING

PART 1 GENERAL

1.01 REFERENCES

- A. The following is a list of standards which may be referenced in this section:
 - 1. Factory Mutual.
 - 2. Institute of Electrical and Electronics engineers, Inc. (IEEE): 515, Testing, Design, Installation and Maintenance of Electrical Resistance Heat Tracing for Industrial Applications.
 - 3. National Electrical Manufacturers' Association (NEMA): 250, Enclosures for Electrical Equipment (1,000 Volts Maximum).
 - 4. Underwriters Laboratories, Inc. (UL).

1.02 SUBMITTALS

- A. Action Submittals:
 - 1. Manufacturer's descriptive literature.
 - 2. Plastic Pipe Installations: Output adjustment factors for heating tape for the services indicated.
 - 3. Pipe heat loss calculations for each pipe size to be heat traced.

1.03 QUALITY ASSURANCE

- A. Authority Having Jurisdiction (AHJ):
 - 1. Provide the Work in accordance with NFPA 70. Where required by the AHJ, material and equipment shall be labeled or listed by a nationally recognized testing laboratory or other organization acceptable to the AHJ in order to provide a basis for approval under NEC.
 - 2. Materials and equipment manufactured within the scope of standards published by Underwriters Laboratories Inc. shall conform to those standards and shall have an applied UL listing mark.

PART 2 PRODUCTS

2.01 SYSTEM DESIGN REQUIREMENTS

- A. Design Heating Load:
 - 1. Heating load to be calculated based upon a 40 degree F delta, 20 mph wind if pipes are located outdoors, insulation as specified in Section 40 42 13, Process Piping Insulation 15112, pipe as specified in Section 15110, Process Piping-General, and shall include a 10 percent safety factor.
 - 2. Heat loss calculations shall be based on IEEE 515, Equation 1, Page 19.

2.02 ELECTRICAL HEATING TAPE

- A. Cable: Self-limiting, parallel circuit construction consisting of continuous inner core of variable resistance conductive heating material between two parallel copper bus wires. Provide tinned copper braid for PVC, FRP, and stainless steel pipe applications.
- B. UL Listing: Listed as self-limiting pipe tracing material for pipe freeze protection application in ordinary conditions.
- C. Maximum Maintenance Temperature: 150 degrees F (65 degrees C).
- D. Maximum Intermittent Temperature: 185 degrees F (85 degrees C).
- E. Service Voltage: As indicated by branch circuits provided for heat tracing on the Drawings.
- F. Manufacturers and Products:
 - 1. Raychem; BTV-CR.
 - 2. Thermon; BSX.
 - 3. Nelson; CLI-JL or LI-JL.

2.03 CONNECTION SYSTEM

- A. Rating: NEMA 250, Type 4 and Factory Mutual approved.
- B. Operating Monitor Light: Furnish with each circuit power connection kit to indicate when heat tracing is energized.
- C. Manufacturers and Products:
 - 1. Power Connection Kit:
 - a. Raychem; JBS-100.
 - b. Thermon; PCA-1-SR or DP-L.
 - c. Nelson; PLT-BC.
 - 2. Splice Kit:
 - a. Raychem; S-150.
 - b. Thermon; PCS-1-SR.
 - c. Nelson; PLT-BY.
 - 3. Tee Kit:
 - a. Raychem; T-100.
 - b. Thermon; DS-S.
 - c. Nelson; PLT-BY.
 - 4. End Seal Kit:
 - a. Raychem; E-150.

- b. Thermon; DE-S.
- c. Nelson; LT-ME.
- 5. Lighted End Seal Kit:
 - a. Raychem; E-100-L.
 - b. Thermon; DLS.
 - c. Nelson; LT-L.

2.04 SECURING TAPE

- A. Plastic Piping Systems:
 - 1. Type: Aluminum foil coated adhesive tape.
 - 2. Manufacturers and Products:
 - a. Raychem; AT-180.
 - b. Thermon; AL-20P.
 - c. Nelson; AT-50.
- B. Metallic Piping Systems:
 - 1. Type: Glass or polyester cloth pressure sensitive tape.
 - 2. Manufacturers and Products:
 - a. Raychem; GS54 or GT66.
 - b. Thermon; PF-1.
 - c. Nelson; GT-6 or GT-60.

2.05 PIPE MOUNTED THERMOSTAT

- A. Type: Fixed, nonadjustable, set at 40 degrees F.
- B. Sensor: Fluid-filled with 3-foot capillary.
- C. Enclosure: Glass-filled nylon, NEMA 250, Type 4X weatherproof with gasketed lid.
- D. Switch: SP-ST, UL listed, rated 22 amps, 120 to 240V ac.
- E. Manufacturers and Products:
 - 1. Raychem; DigiTrace Model AMC-F5.
 - 2. Thermon; E4X-1.
 - 3. Raychem; DigiTrace Model E507S-LS for hazardous areas.
 - 4. Thermon; E7-25325 for hazardous areas.

2.06 AMBIENT THERMOSTAT

- A. Type: Adjustable setting (15 to 140 degrees F).
- B. Sensor: Fluid-filled probe.

- C. Enclosure: Epoxy-coated NEMA 250, Type 4X aluminum closure with exposed hardware of stainless steel.
- D. Switch: SP-DT, UL or FM listed, rated 22 amps, 125 to 250V ac.
- E. Manufacturers and Products:
 - 1. Raychem; DigiTrace Model AMC-IA.
 - 2. Thermon; B4X-15140.
 - 3. Raychem; DigiTrace Model AMC-IH for hazardous areas.
 - 4. Thermon; B7-15140 for hazardous areas.

PART 3 EXECUTION

3.01 INSTALLATION

- A. General:
 - 1. Install in accordance with the manufacturer's instructions and recommended practices.
 - 2. Provide insulation as specified in Section 15112, Process Piping Insulation, over all pipe heat tracing.
 - 3. Ground metallic structures or materials used for support of heating cable or on which it is installed in accordance with applicable codes.
 - 4. Wiring between power connection points of heat tracing cable branch lines shall be provided by heat tracing system supplier.
 - 5. Provide end of circuit pilot lights on heat tracing circuits for buried piping.
- B. Electrical Heating Tape:
 - 1. Determine required length of electrical heating tape by considering length of circuit, number and type of fittings and fixtures, design heating load, and heating tape output.
 - 2. Where design heating load exceeds heating tape capacity, install by spiraling.
 - 3. Derate heating tape capacity when installed on plastic piping.
 - 4. Install on services as follows:

Service	Piping Material	Placement	Location
Sludge Piping	DIP		Sludge collection system valves and above grade piping. Thickened Sludge Pump Piping.

PIPE HEAT TRACING

5. Install additional heating tape at bolted flanges, valves, pipe supports, and other fittings and fixtures as recommended by supplier, but not less than the following:

Item	Heating Tape Length (min. feet)
Bolted flanges (per pair)	Two times pipe diameter
Valves	Four times valve length
Pipe hanger or support penetrating insulation	Three times pipe diameter

- C. Heat Tracing Circuits: Limit individual lengths of heat tracing circuits such that maximum single circuit capacity is 20 amps when starting the circuit at 40 degrees F. Provide multiple 20-amp circuits as required at individual heat tracing locations.
- D. Thermostats:
 1. Install in accordance with manufacturer's instructions and as approved by Engineer.
 2. For each group of heat traced circuit, install one ambient thermostat.

3.02 FIELD QUALITY CONTROL


- A. Test each circuit with 500-volt insulation tester between circuit and ground with neutrals isolated from ground.
 1. Insulation Resistance: Minimum 1,000 megohms per 1,000 feet.

END OF SECTION



CLIENT _____ DATE _____ SHEET _____ OF _____
 PROJECT _____ BY _____
 SUBJECT _____ CHECKED BY _____
 JOB NO. _____ DATE CHECKED _____

Aloe Bay Water Quality Enhancement Wastewater Treatment Facility Pre-Bid Sign in sheet				
Name	Company	Contact Phone number	Email	
Tim Murrish	Humphill	601-530-2475	Tmurrish@humphillconstruction.com	
Frankie Lane	Creel Co	251-487-0236	EFL@theCreelcompany.com	
JEFF NECAISE	SOUTHERN EXTERIORS FENCE CO.	228 586 2110	JNECAISE@JEFFENCE.COM	
JOSH CHADICK	HYDRA SERVICE INC	228-337-0618	JCHADICK@HYDRASERVICE.NET	
Brandon Bodin	Mersino Water Solution	251-293-3593	brandon.bodin@mersinowater.com	
Vaile Fermeter	D.I. Water	251-861-2363	diwsa@aol.com	
Zeb Brown	Dorman and Associates	251-509-6319 or 251-231-0543	scottiedorman@gmail.com BrownConstruction@live.com	
CHAS ALFORD	PRECON CORPORATION	352-328-0461	CJA@PRECONTANKS.COM	
Mike Hill	Victaulic	504-508-0192	MIV@PRECONTANKS.COM Michael.Hill@Victaulic.com	
JACK MORPHET	HAREN	423-826-4840	JACK MORPHET @ HAREN CONSTRUCTION.COM	
Kevin Creel	The Creel Co.	251-460-2722	kpc@theCreelcompany.com	
Tim Boyne	Templeton + Assoc.	205.500.2168	tim@templeton-associates.com	
ERIC Coley	ACS	850-477-8440 x104	eric.Coley@Autoconserv.com	
Alan Raymond	CRom	352 810 0673	araymond@Cromcorp.com	

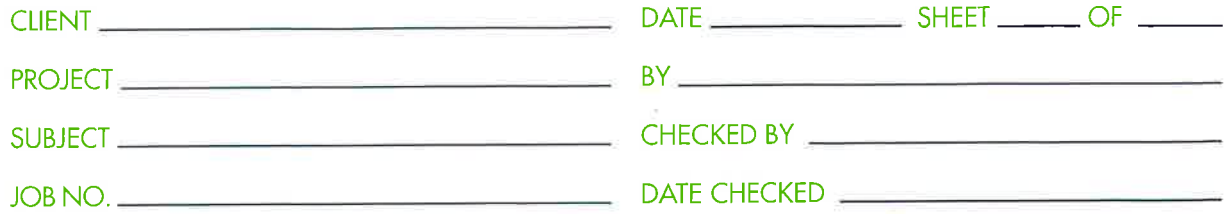[illegible]